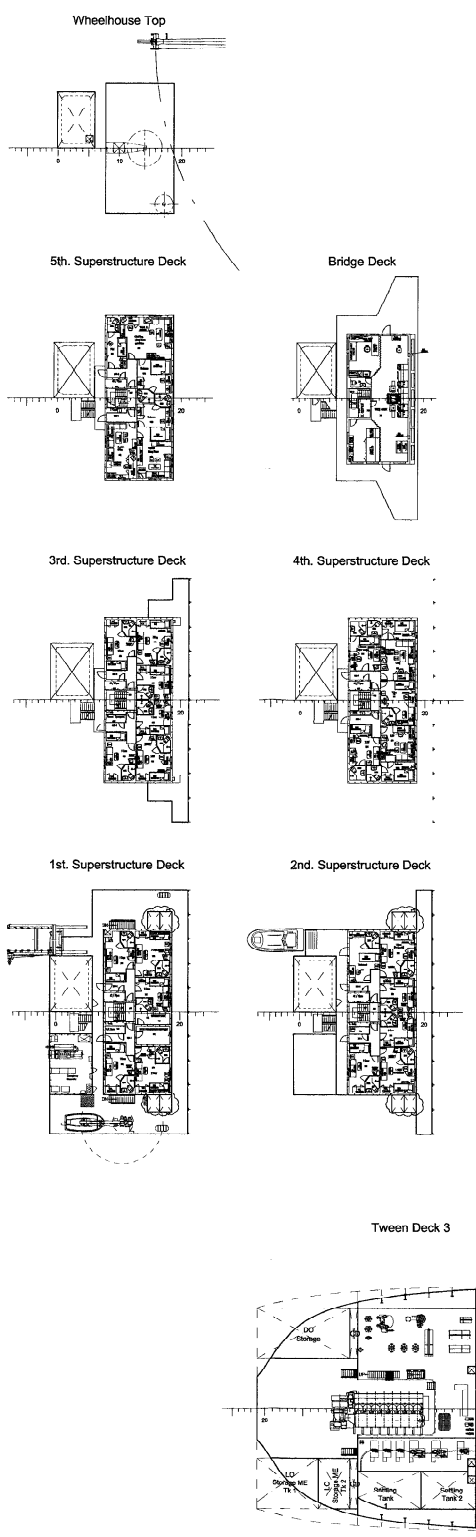

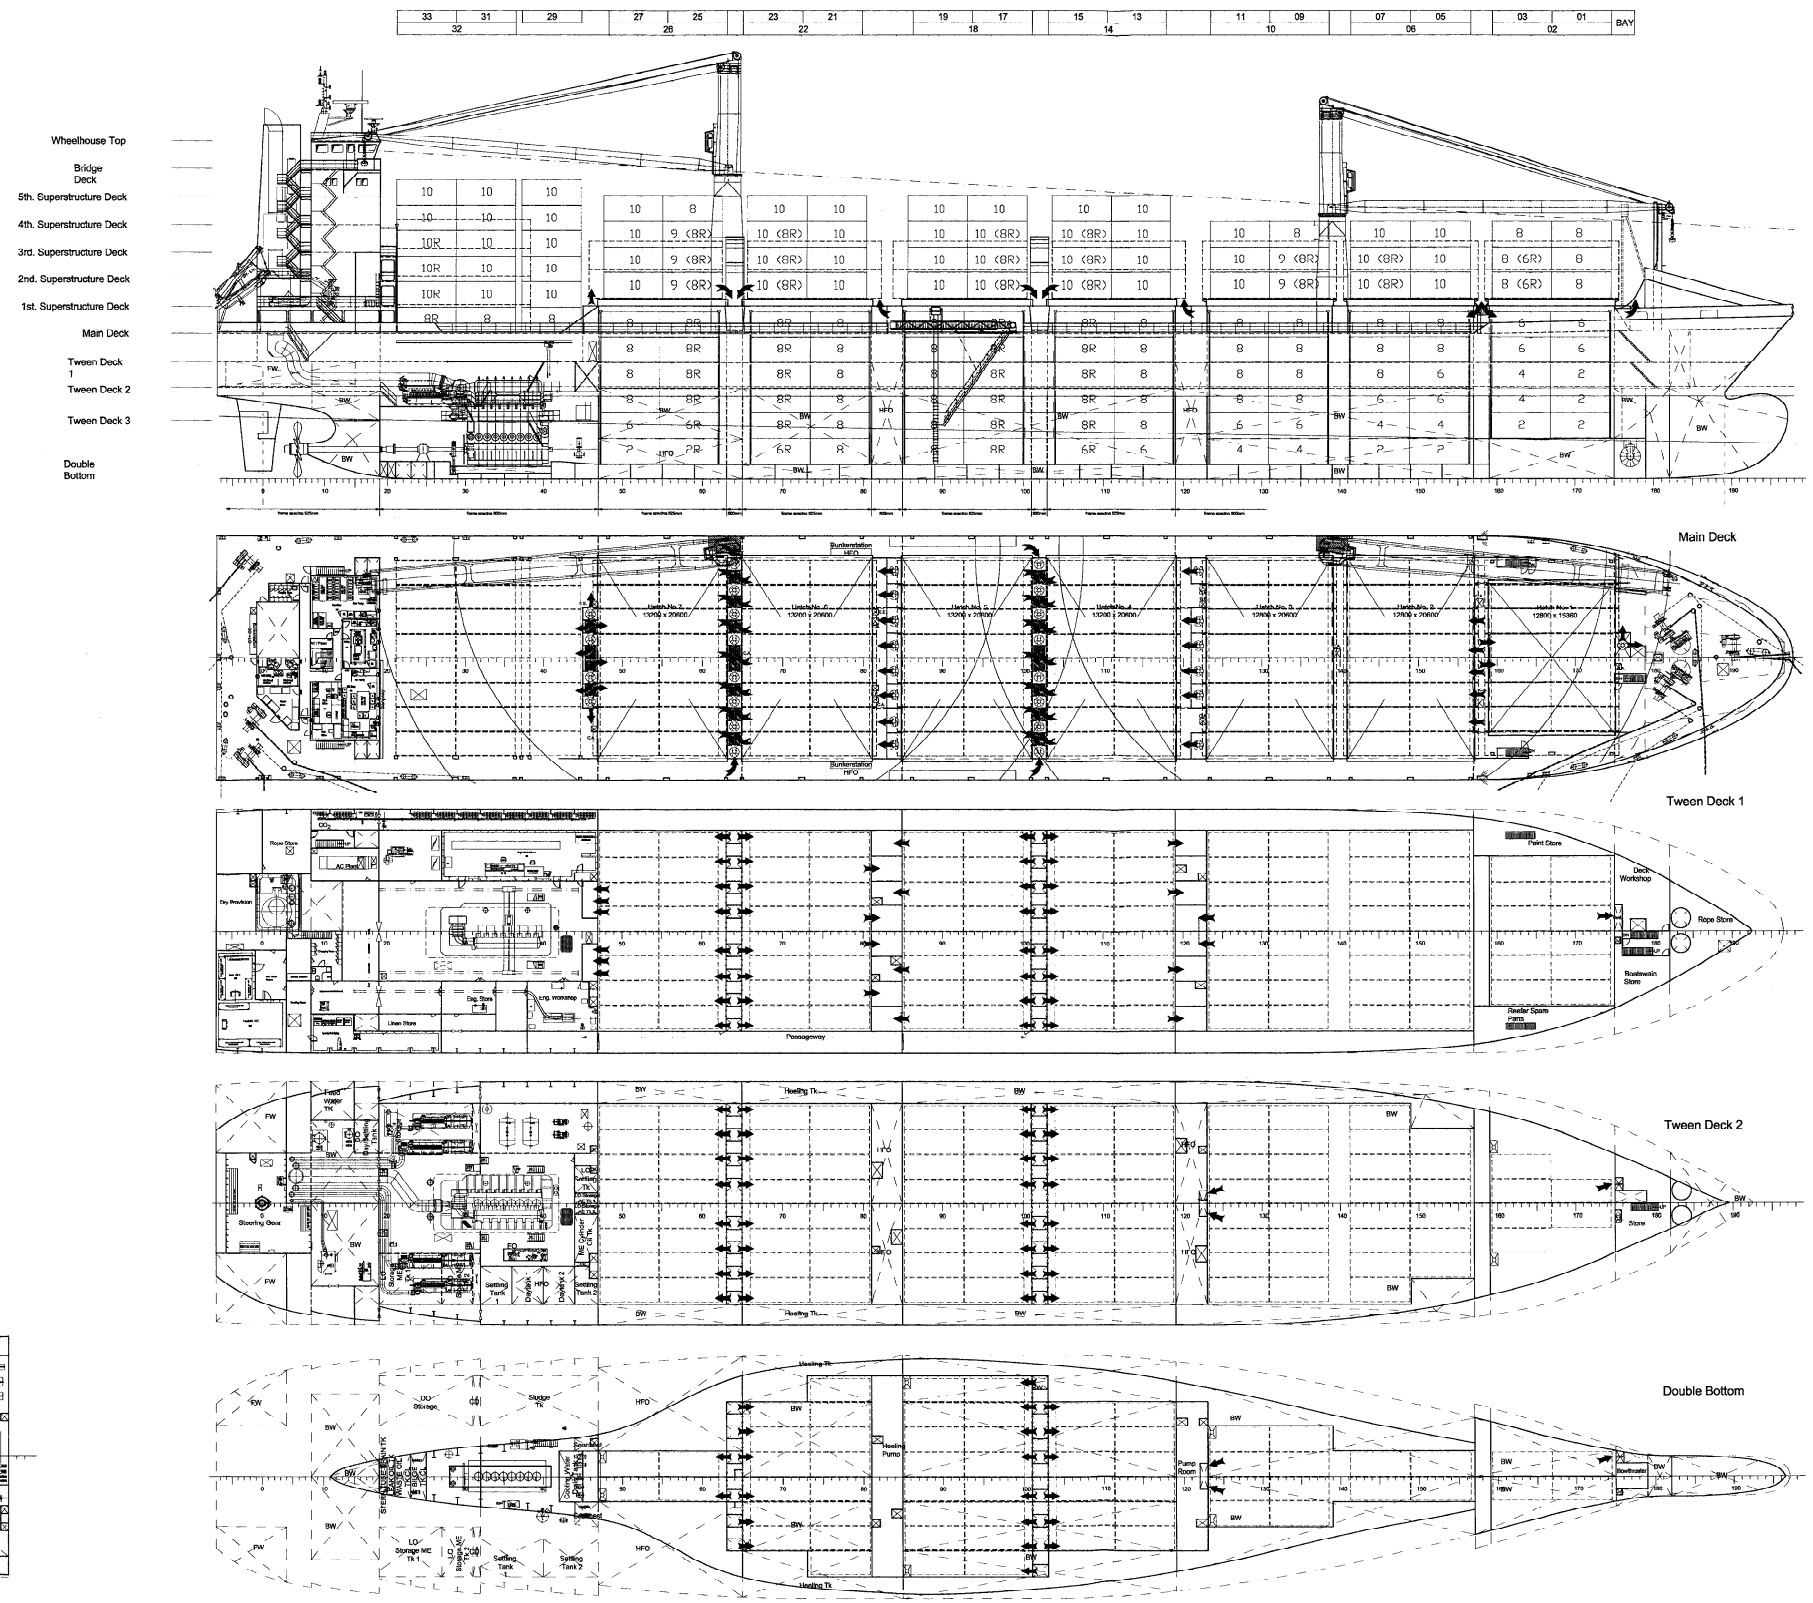

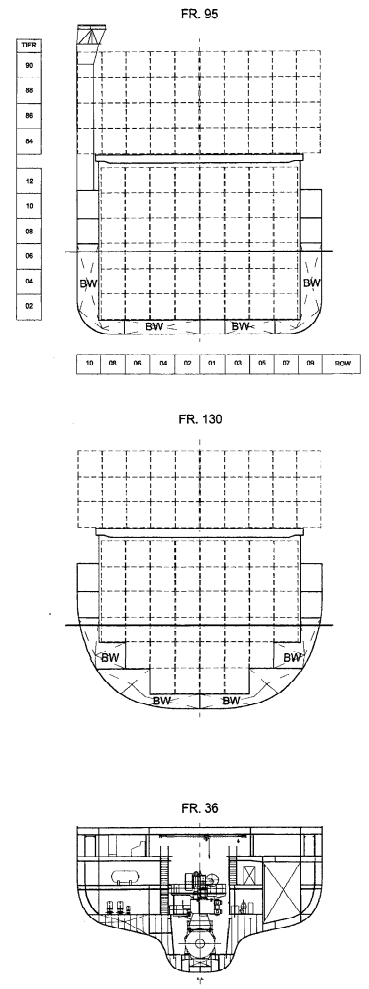

1180 TEU Container Vessel

PRINCIPAL PARTICULARS:

LENGTH (O.A.)	appr.	161.30 m
LENGTH (B.P.)		149.60 m
BREADTH		25.00 m
DEPTH		14.90 m
DESIGN DRAUGHT		8.50 m
SCANTLING DRAUGHT		9.50 m
SERVICE SPEED		19.20 kn

All Holds fitted with Collguidco

FINAL DRAWING

SHIPNAME		FORTINA J	
PLAN NO. SDC1283-0101.00		1180TEU REEFER CONTAINER VESSEL	HULL NO. YL-0288-4/5/C3
DESIGNED		General Arrangement Plan	AS BUILT
CHECKED			SCALE: 1:200
VERIFIED			
CHK OF STAND			
APPROVED			
SDARI	SHANGHAI MERCHANT SHIP DESIGN & RESEARCH INSTITUTE	JIANGSU YANGZI SHIPBUILDING CO., LTD.	PAGE:1/1